



PARTIAL AS-BUILT
SCALE 1/4"=1'-0"

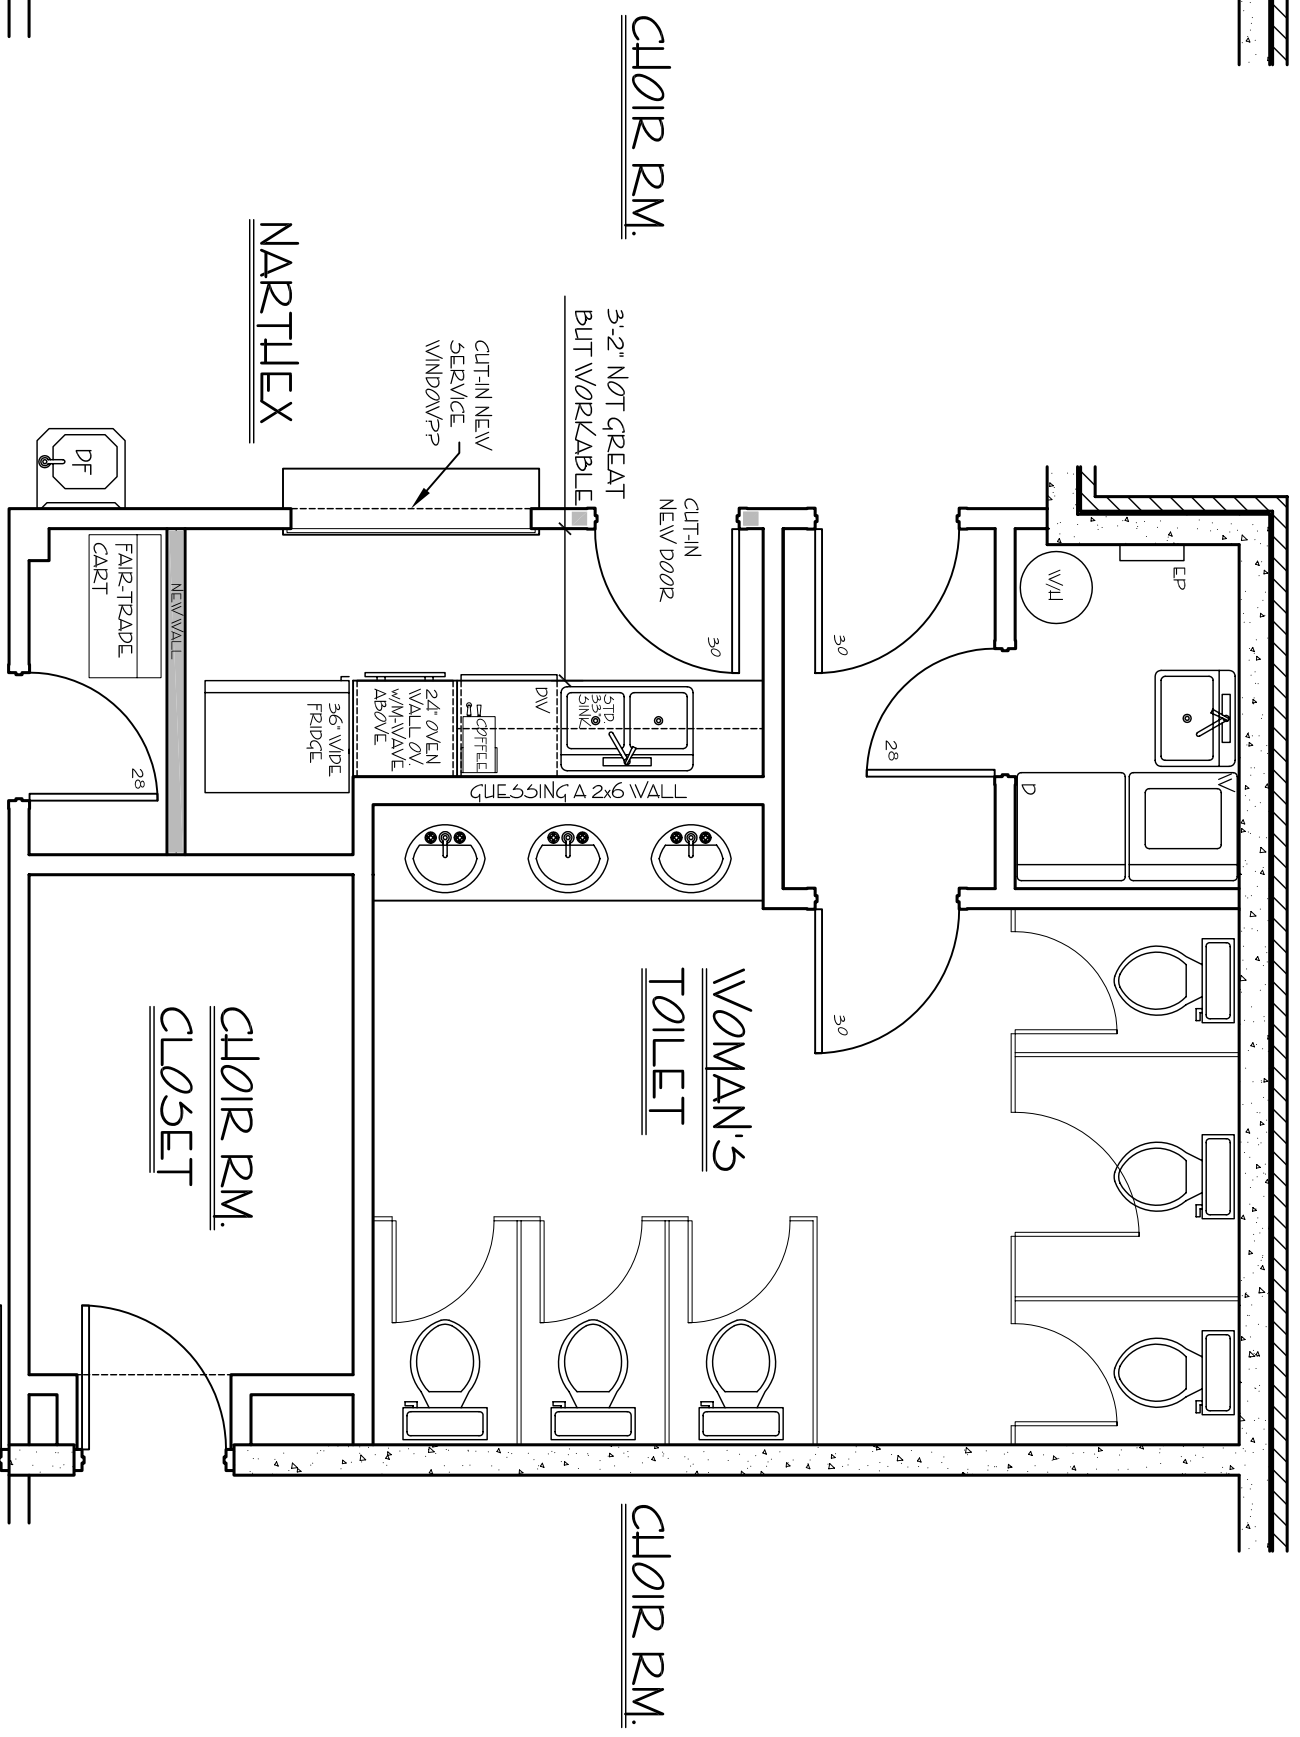

THE "TURBO" KITCHENETTE
SCALE 1/4"=1'-0"

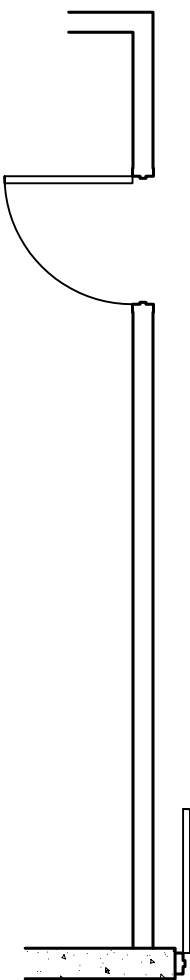